



Ship's Name or No. 3 7 4

Name CONSTRUCTION PROFILE AND
of
Drawing DECK PLANS. (ALTERED)


Drawing No.

Sending No.

~~GEN. BOX NO.~~

591

M/S "KATSUR'GI "TARU",

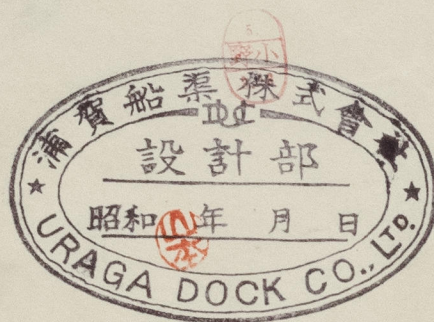


© 2020


Lloyd's Register
Foundation

007658-007667-0245

No 374
CONSTRUCTION PROFILE & DECK PLANS
SCALE 1/8"=1' (SHEET NO. 1)

 

APPROVED
MAR 25 1938
ROBE

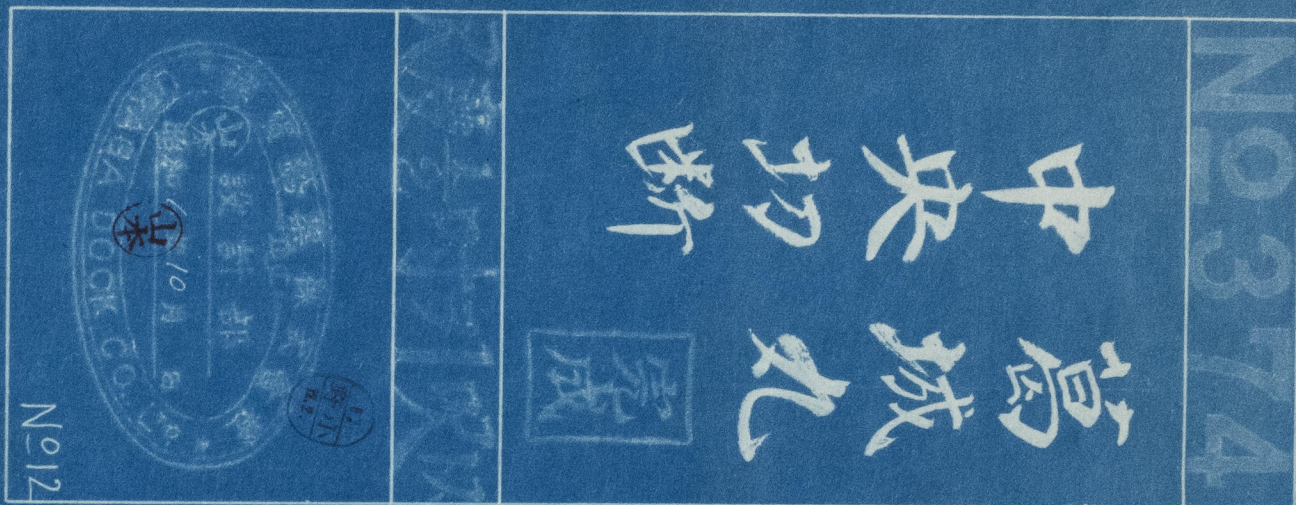

"Katsuragi Maru"

*Midship Section
(as built)*



© 2020

Lloyd's Register
Foundation

007658-007667-0244

SS. CARGO MOTOR SHIP "KATSURAGI-MARU"
MIDSHIP SECTION
SCALE 1/4" = 1'-0"

TYPE OF THE SHIP: STEEL DECK WITH TONNAGE OPENING
CLASS: TEIJUNSHINOS 1st CLASS 1st DIV. WITH FREEBOARD OF 11'-0"

N.B.: STANDARD & BULK HEADS TO BE OF THE
STANDARD SECTION AREA BEHIND THE

PRINCIPAL DIMENSIONS

LENGTH 111'-0"
BREADTH 36'-0"
DEPTH 40'-0" (TO SHUTTER DECK)

SCANTLING NUMERALS












Sketch

Ship's Name or No. 3 7 4.	
Name RUDDER AND STERN FRAME.	
of	
Drawing	
Drawing No.	Sending No.

8/5

"KABURAGI MARU."

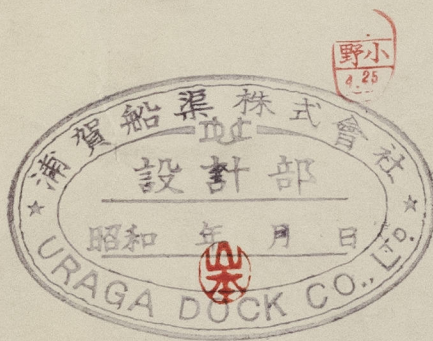

© 2020

Lloyd's Register
Foundation

007658-007667-0243



舵及舵尾骨材

工事区分 船11号

工	士	1	1	1
場	原	4		5
造	木	1	1	3
所	及	利	世	督
	數	工	1	用
		機	水	4
		鐵	壓	
		2		

111 666. 船殼

DETAIL
SCALE 1" = 1 FT.

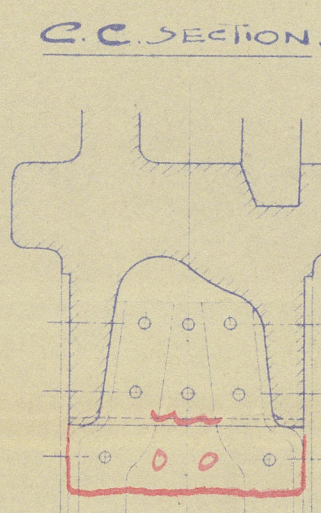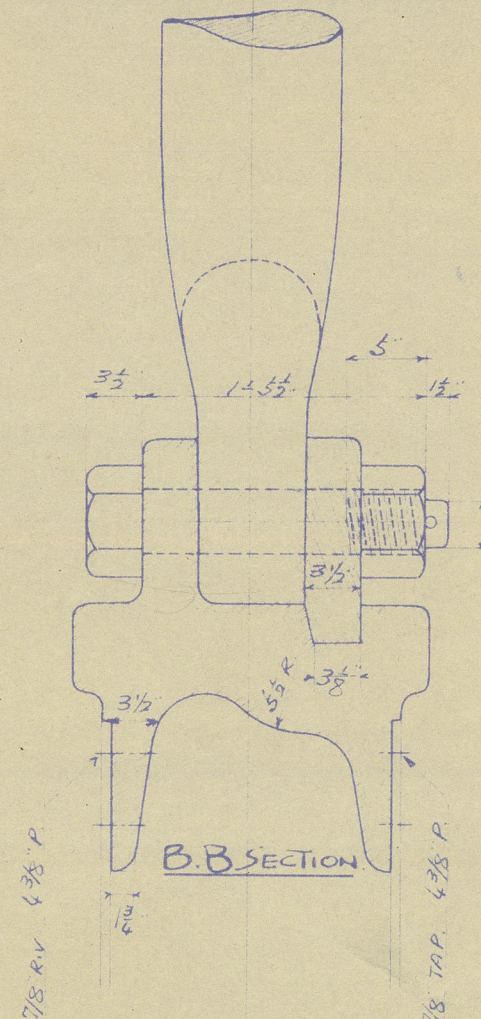

<u>NUMERALS & SPEED.</u>	
A	127 $\frac{1}{2}$
D	3.19'
A x D	405
SPEED.	17 KNOTS (AT LIGHT CONDITION)

MATERIALS.

STERN FRAME. CAST STEEL.

RUDDER ARMS. " "

RUDDER HEAD. FORGED "

PINTLES. " "

APPROVED
LLOYD'S REGISTER OF SHIPPING
MAY 1 1900
K O B E